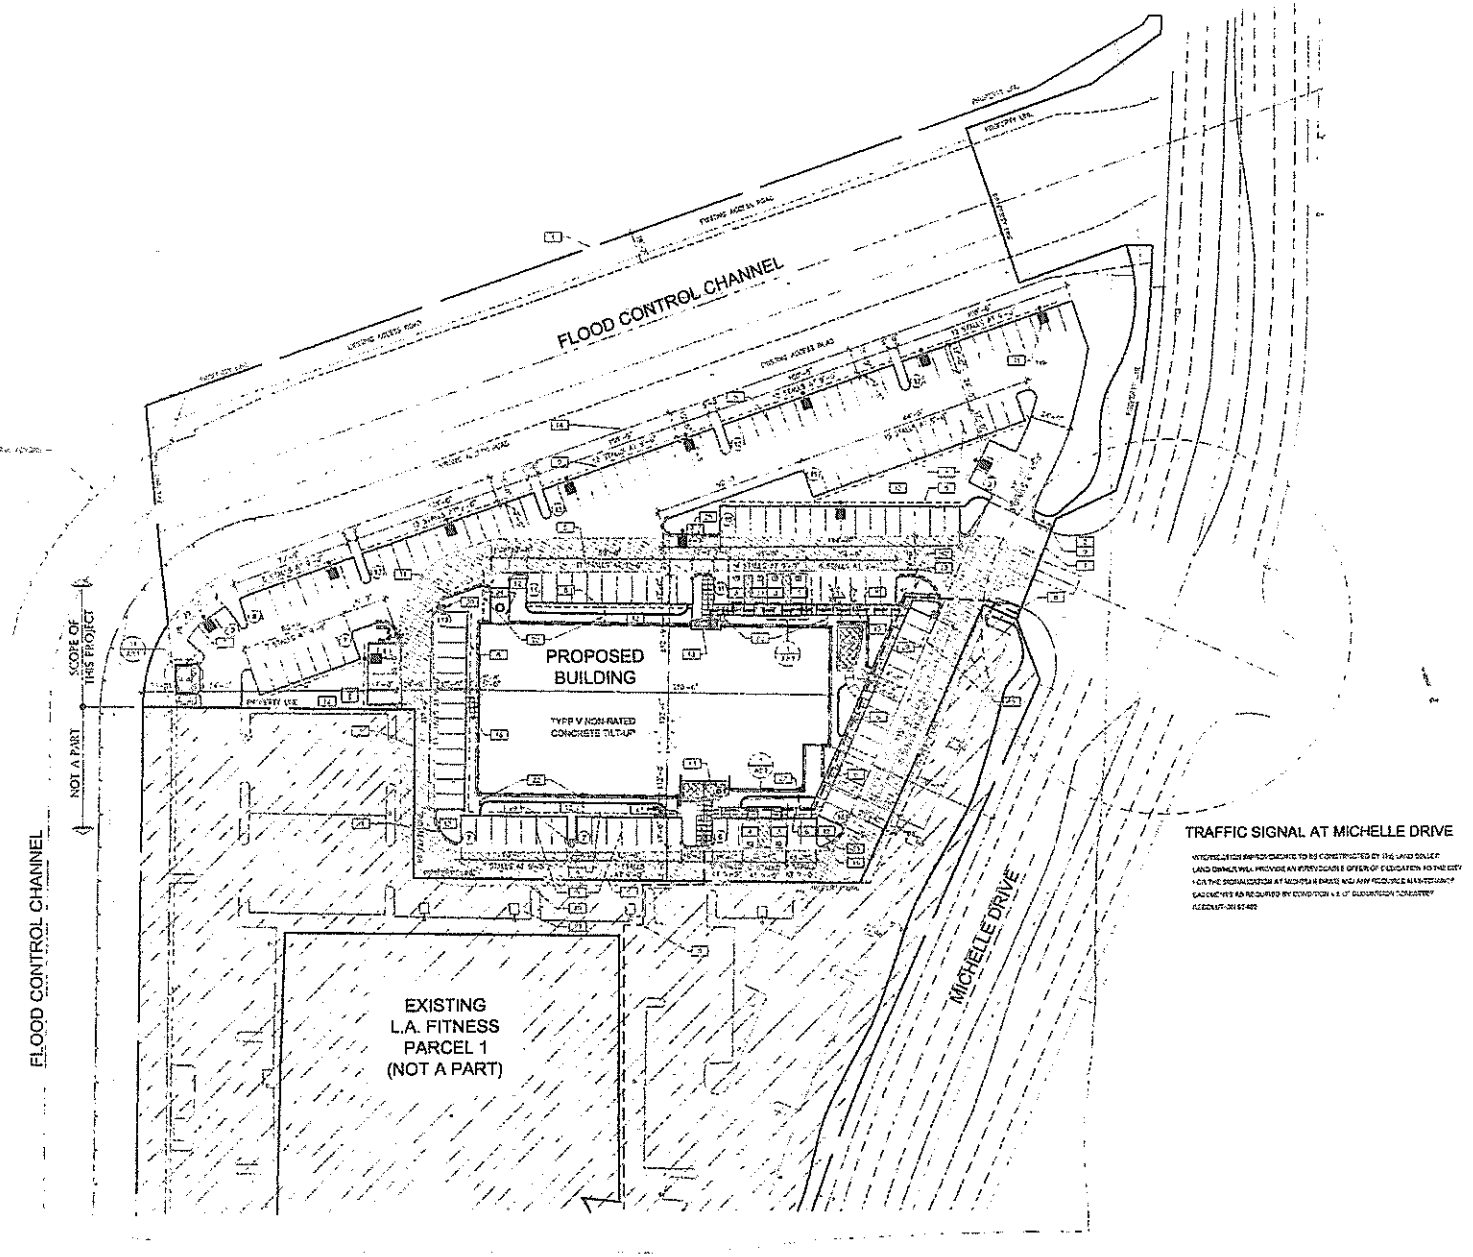

SITE PLAN

TRAFFIC SIGNAL AT MICHELLE DRIVE

INTERSECTION IMPROVEMENTS TO BE CONSTRUCTED BY THE LAND OWNER. LAND OWNER WILL PROVIDE AN IRREVOCABLE OFFER OF DEDICATION TO THE CITY FOR THE SIGNALIZATION AT MICHELLE DRIVE AND ANY REQUIRED MAINTENANCE EASEMENTS AS REQUIRED BY CONDITION 1.8.1 OF SUBDIVISION TENTATIVE TRACT MAP 15487

RECORD DRAWINGS
MOOREFIELD CONST. INC.

SITE PLAN NOTES

SITE PLAN GENERAL NOTES

SITE DATA:

APPROVED PLANS:

SITE LEGEND

WARE MALCOMB

KAHL & GOVEIA
JAMBOREE BUSINESS CENTER
IRVINE CALIFORNIA

SITE PLAN

A1.1